AS BUILT DRAWING

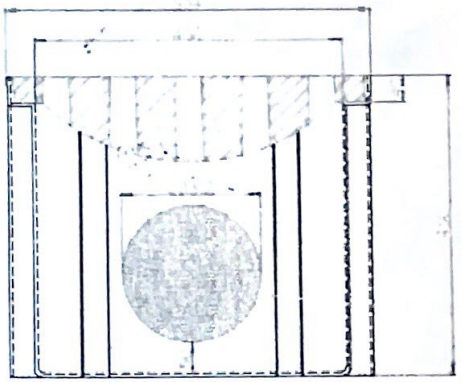

ELEVATION

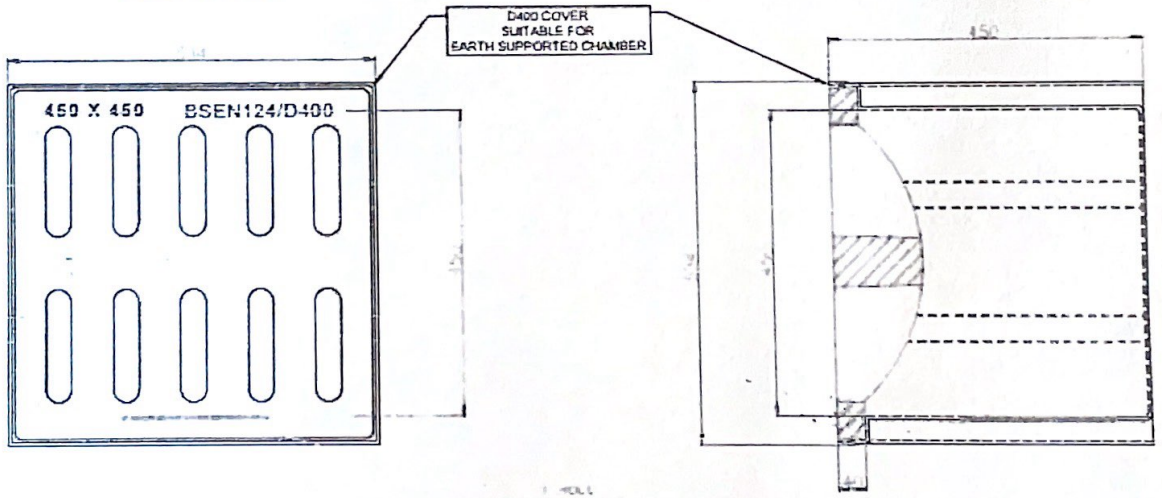

PLAN **SIDE VIEW**

NOTE- 1. ALL DIMENSIONS ARE IN MM.
2. ALL LOAD BEARING CONFIRM TO TESTING AS PER BSEN 124: 1994.
3. ± 2% DIMENSIONAL VARIATION.